


McMAHON STREET

CHRIS + WENDY PURCELL  
~~SUZANNE BARRATT~~  
 3 McMAHON STREET  
 URALLA  
 LOT27 DP877458

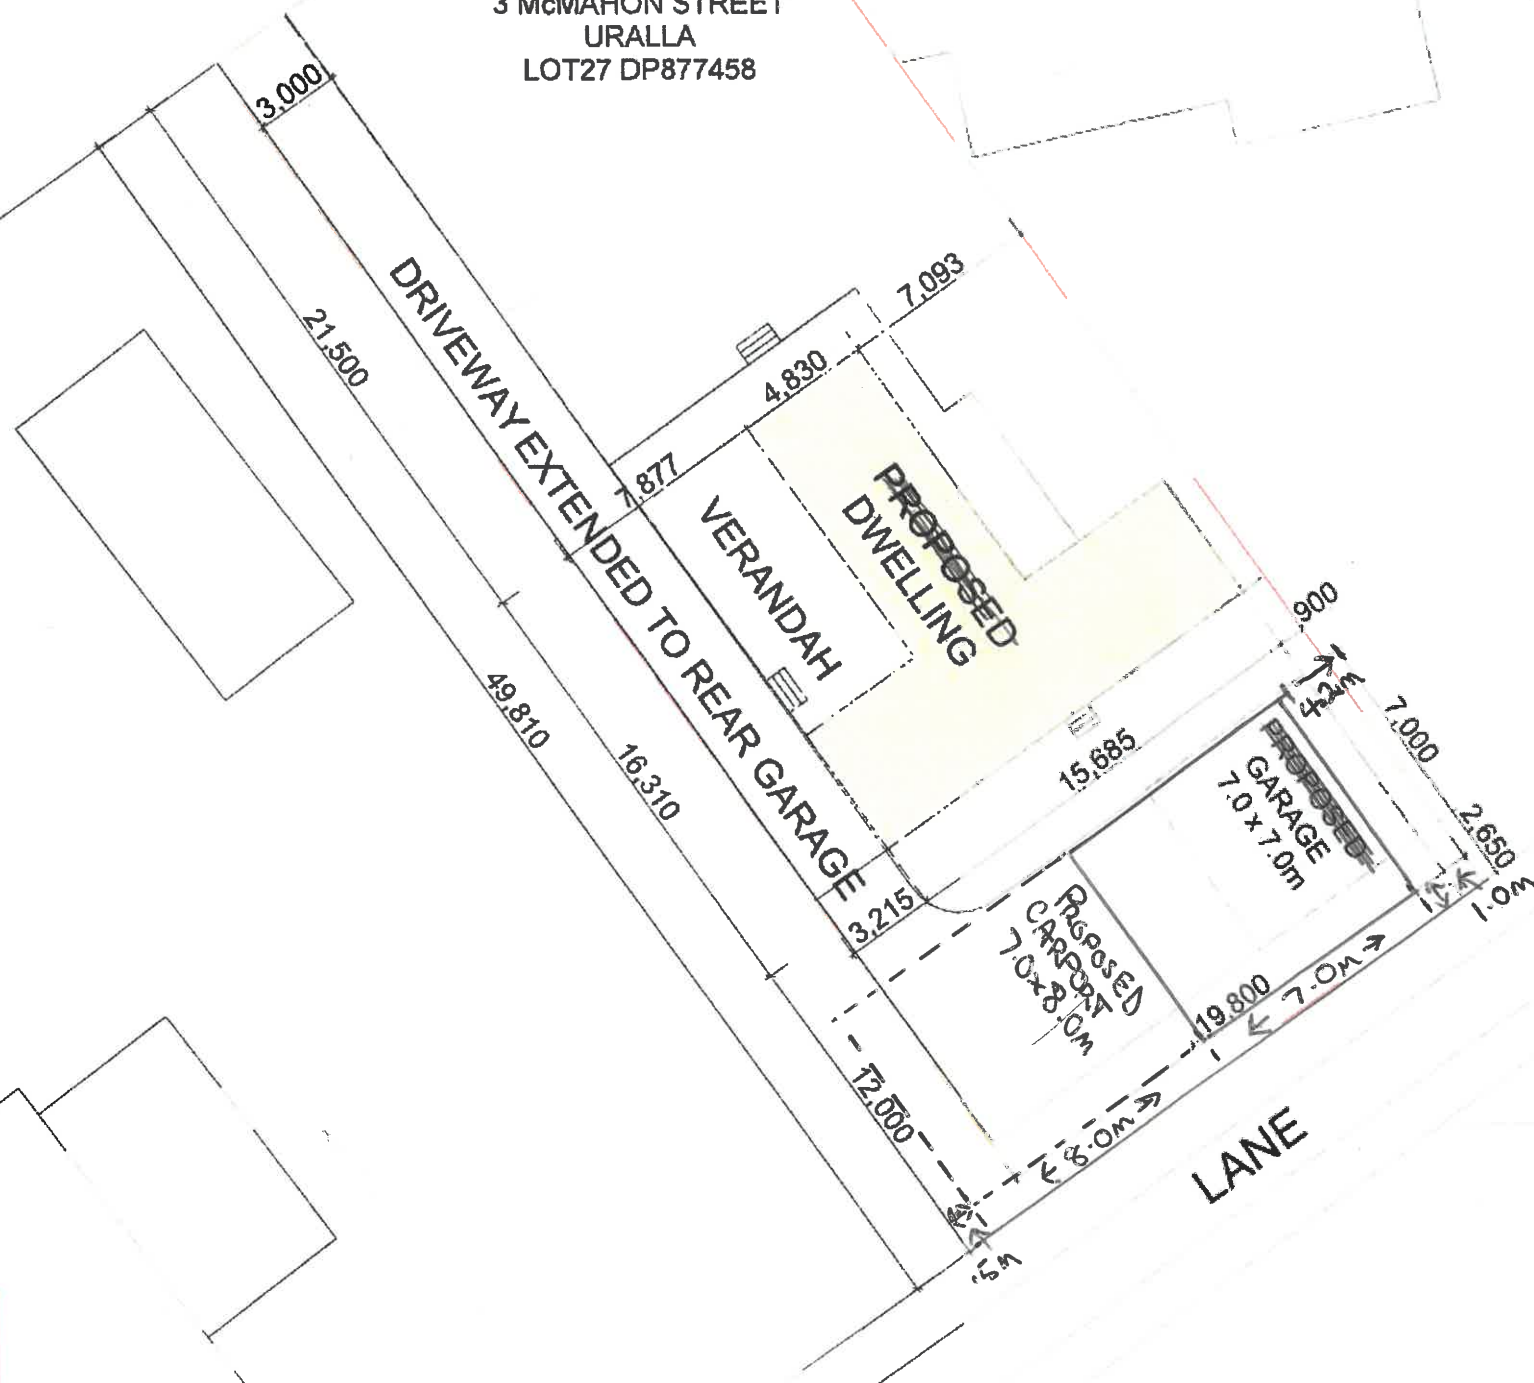

P-02 site plan  
 1:250

**UNIPLAN** GROUP  
 Modern forms. functional design

**AUSTRALIA**  
 22 Myrtle Drive | Armidale NSW 2350  
 PO Box 5004 | Armidale NSW 2350  
 t: +61 2 6773 8500 | f: +61 2 6773 8555  
 FREECALL: 1800 UNIPLAN  
 www.uniplangroup.co | e: sales.au@uniplangroup.co

These drawings are protected by copyright and remain the property of Uniplan Group. They may not be reproduced or copied without permission of Uniplan Group. All site dimensions are to be verified and confirmed by the client prior to the commencement of works. These plans may include optional extras for presentation purposes. Please refer to proposal for inclusions.

client:

~~suzanne barratt~~

project:

proposed three bedroom villa

design by: shm

drawn by: shm

scale: 1:250 on A3

date: 29-Nov-16

site plan

job no:

2128H

sheet no:

2128H-4